

THIS DRAWING IS UNPUBLISHED. RELEASED FOR PUBLICATION -
© COPYRIGHT 19 ALL RIGHTS RESERVED.


LOC	DIST
1	-

REVISIONS


P	LTR	DESCRIPTION	DATE	DWN	APVD
	C5	ECR-23-192331	21NOV2023	PC	TD
	C6	REVISED PER ECR-24-216072	31JUL2024	PC	TD
	C7	REVISED PER ECR-24-218995	02SEP2024	PC	TD
	C8	REVISED PER ECR-25-246433	24JUN2025	TB	PC

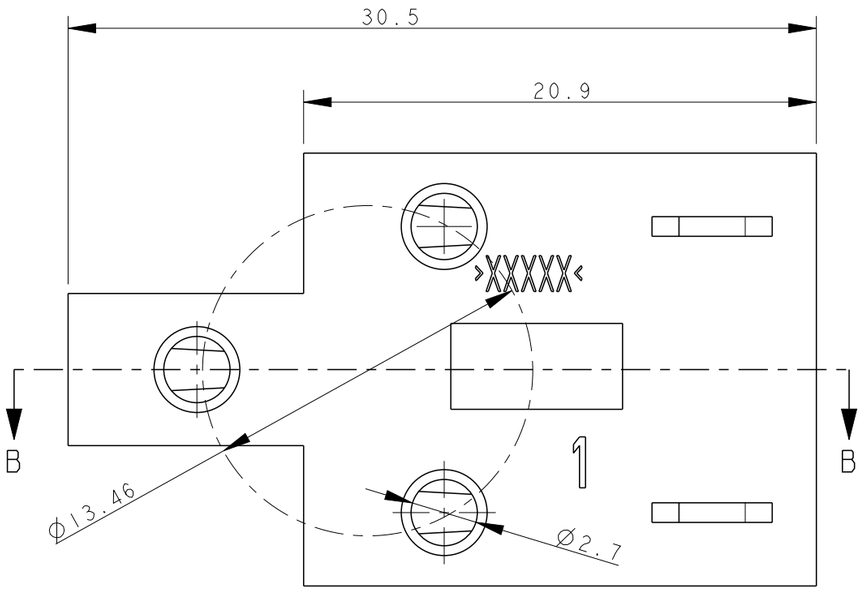


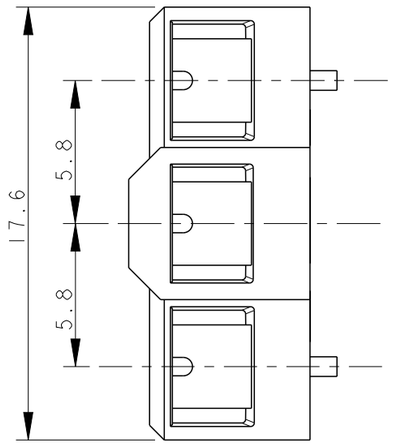

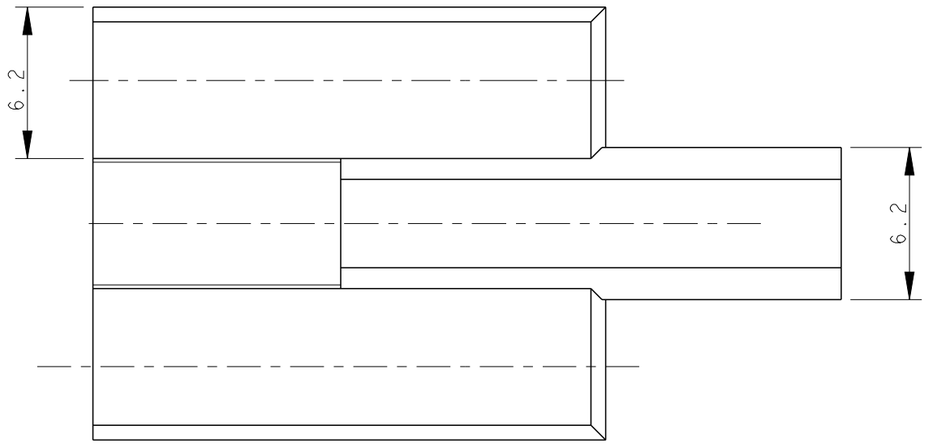


SECTION B-B
(SEZIONE B-B)

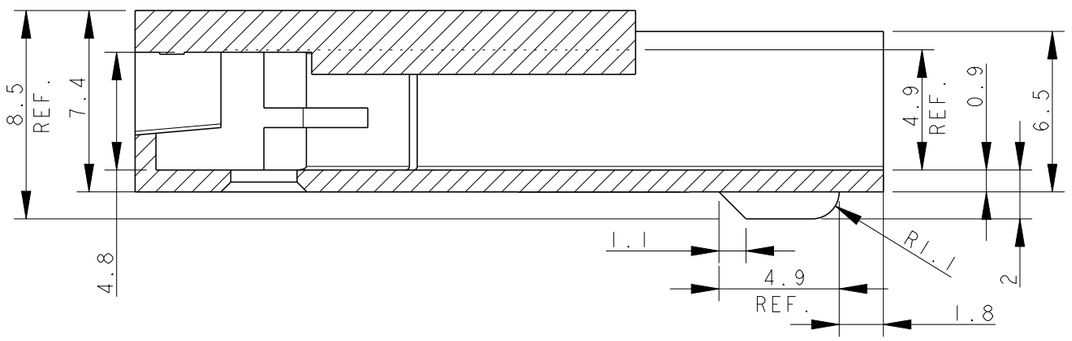

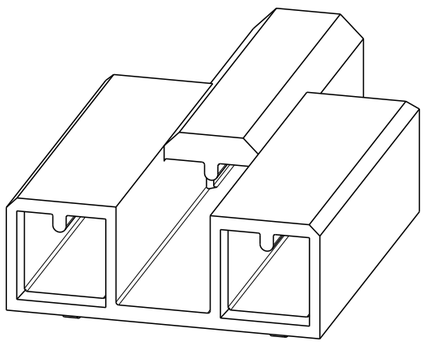

SCALE 3:1
(SCALA 3:1)

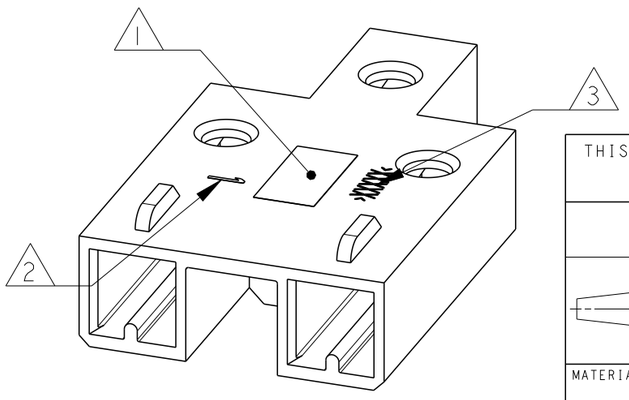

SCALE 3:1
(SCALA 3:1)

1. LOCATION FOR TE LOGO
2. MOULD CAVITY ID. CODE
3. MATERIAL ID. CODE
4. ~~HOUSING AS SHOWN IS SUITABLE FOR CONTACT P/N 284633-1~~
5. HOUSING AS SHOWN IS SUITABLE FOR CONTACT P/N 2178453-1
6. MATERIAL PA6 15%GF, GWT(Glow Wire Test) 750° C WITHOUT FLAME ACCORDING TO IEC-60695-2-11.
7. PRELIMINARY PART- NOT YET RELEASED FOR PRODUCTION

COLOUR (COLORE)	MATERIAL (MATERIALE)	PART NO
YELLOW	PBT GLASSFIBRE FILLED	284406-4
NATURAL	PBT GLASSFIBRE FILLED	284406-3 5
NATURAL	PBT GLASSFIBRE FILLED	284406-2 7
NATURAL	PA6 GF15% 6	9-284406-1 7
~~NATURAL~~	PBT 30% CARICATO VETRO (PBT GLASSFIBRE FILLED)	~~284406-1~~ 4

THIS DRAWING IS A CONTROLLED DOCUMENT.

DIMENSIONS: mm

TOLERANCES UNLESS OTHERWISE SPECIFIED:

0 PLC	± 0.5
1 PLC	± 0.3
2 PLC	± 0.15
3 PLC	± -
4 PLC	± -
ANGLES	± 2′

MATERIAL: See table (vedi tabella)

FINISH: -

DWN	C.CORDOLA	16SEPT.99
CHK	C. CORDOLA	16SEPT.99
APVD	G. TURCO	16SEPT.99

PRODUCT SPEC: 108-20033

APPLICATION SPEC: -

WEIGHT: -

TE Connectivity

NAME: CLUSTER BLOCK REVERSE HOUSING .090 DIA

SIZE	CAGE CODE	DRAWING NO	RESTRICTED TO
A3		C-284406	-

CUSTOMER DRAWING

SCALE	SHEET	REV
4:1	1 OF 1	C7